
 


GROUND FLOOR PLAN \_ DOWNTAKINGS

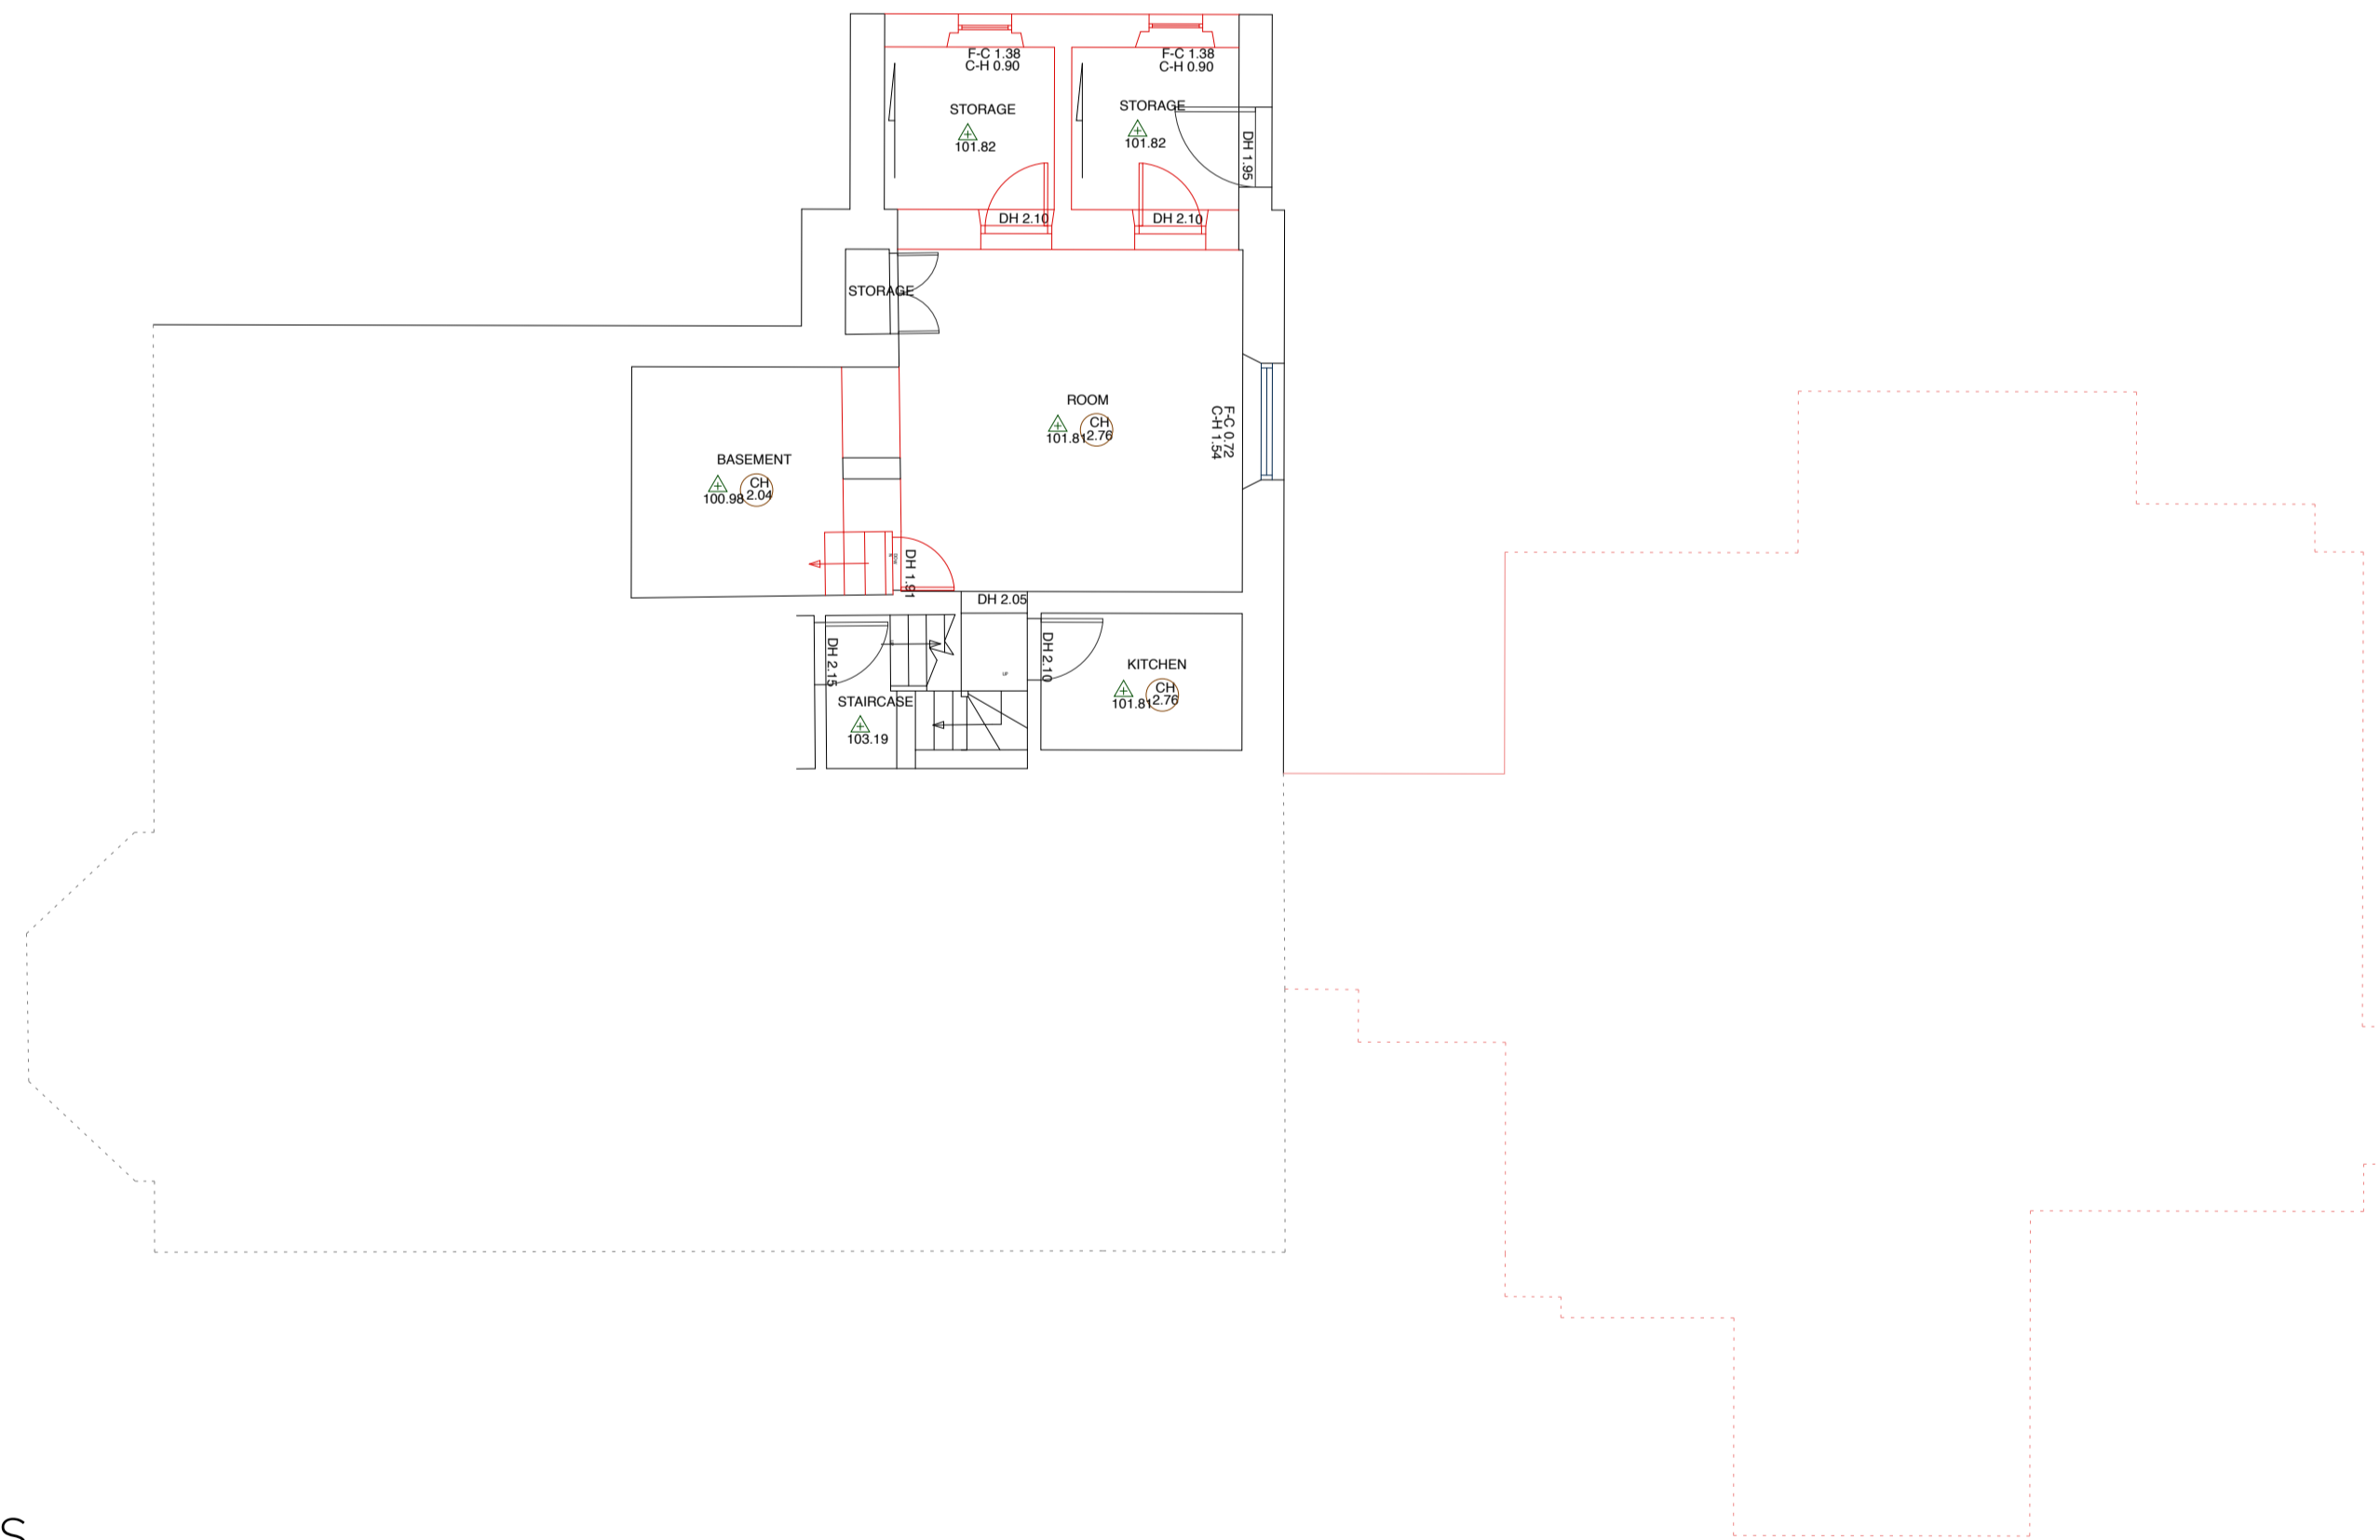


LOWER GROUND FLOOR PLAN \_ DOWNTAKINGS



RED LINE denotes components and structures to be removed.



Scale

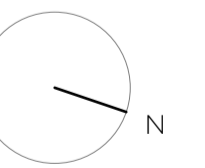

LEAD CONSULTANT / ARCHITECT:	ROBIN LEE ARCHITECTURE
QUANTITY SURVEYOR:	SAMMON
STRUCTURAL & CIVIL ENGINEER:	CORA
MECHANICAL & ELECTRICAL ENGINEER:	DELAP & WALLER

Issue	Description	Date	Drawn	Check
P1	PART 8 APPLICATION	01.12.2022	OC	RL

USE FIGURED DIMENSIONS ONLY - DO NOT SCALE FROM DRAWINGS - ALL DIMENSIONS TO BE CHECKED ON SITE - DRAWINGS TO BE READ IN CONJUNCTION WITH RELEVANT CONSULTANT DRAWINGS - ANY DISCREPANCIES TO BE REPORTED TO THE ARCHITECT COPYRIGHT ROBIN LEE ARCHITECTURE

<b>ROBIN LEE ARCHITECTURE</b>		Project	<b>22011</b>
71 Queensway London W2 4QH		<b>YOUTH AND FURTHER EDUCATION TRAINING CENTRE DAN BREEN HOUSE, TIPPERARY</b>	Project No.
T: 020 3368 6724 E: info@robinleearchitecture.com W: www.robinleearchitecture.com		Client	<b>TIPPERARY COUNTY COUNCIL</b>
		Date	Dec 2022
		Scale / Format	1:100 / A1
		Drawn / Checked	OC / RL
		Drawing Name	Lower Ground/Ground Plan_Downtakings
		Issue	P1